


SECTION 26, TOWNSHIP 28 SOUTH, RANGE 15 EAST City of Dunedin, Florida

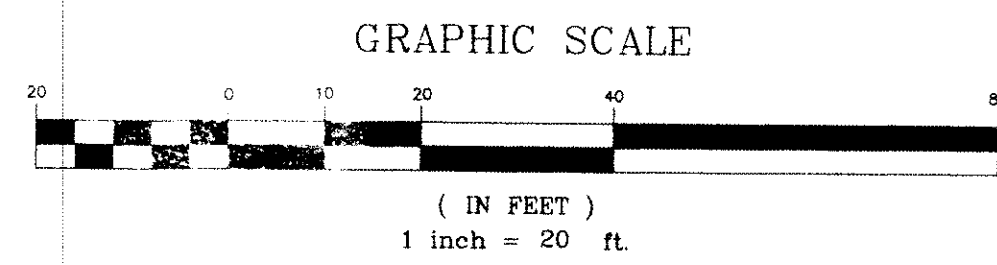

RECORD DRAWING CERTIFICATION
THESE RECORD DRAWINGS HAVE BEEN PREPARED ON 12/22/99 BASED ON INFORMATION PROVIDED BY OTHERS. THE DESIGN PROFESSIONAL HAS NOT VERIFIED THE ACCURACY AND/OR COMPLETENESS OF THIS INFORMATION AND SHALL NOT BE RESPONSIBLE FOR ANY ERRORS OR OMISSIONS WHICH MAY BE INCORPORATED HEREIN AS A RESULT. THE TERM "CERTIFICATION" AS USED HEREIN SHALL BE AS SET FORTH IN FLORIDA STATE BOARD RULE 61C15-18.01(14).

- CONSTRUCTION NOTES**
- FORCEMAIN TO BE DIRECTIONAL BORED TO MINIMIZE EXCAVATION IF REQUIRED.
 - AIR RELEASE VALVE LOCATIONS TO BE LOCATED IN THE FIELD BY THE ENGINEER AND THE CITY OF DUNEDIN.
 - SIDEWALKS TO BE RECONSTRUCTED WITHIN THREE (3) DAYS AFTER REMOVAL AND SAFE PEDESTRIAN TRAFFIC IS TO BE MAINTAINED AT ALL TIMES. WHEN EXISTING SIDEWALK IS REMOVED, IT IS TO BE REMOVED TO THE NEAREST EXPANSION JOINT.
 - PROPOSED 4" FORCE MAIN FOR DIRECTIONAL BORE TO BE CLASS 200 DR-14 C900/RJ PVC PIPE

OFFSITE FORCEMAIN ROUTE

REVISIONS 10-20-98 RELOCATE FORCE MAIN TO EAST SIDE OF ROAD 09-30-98 REVISED ADDITIONAL LOCATION ON EAST SIDE OF ROAD 05-15-98 REVISED PER CITY OF DUNEDIN COMMENTS DATED 04-16-98 04-27-98 REVISED PER CITY OF DUNEDIN COMMENTS DATED 04-16-98 04-07-98 REVISED PER CITY OF DUNEDIN COMMENTS DATED 03-24-98		
DESIGN JMR Scale: 1"=20' Date: 03-03-98	DRAWN CAD Job No.: 217-04.200	CHECKED JMR Job No.: 217-04.200
PROJECT INFORMATION PROJECT BE 1/2" CAPPE ELEVATION = PROJECT BENCHMARK # 57 CENTER OF 4"x4" CONCRETE MONUMENT FOUND ELEVATION = 28.69 FEET		
CLIENT VIRGINIA CROSSING HIGHMARK DEVELOPMENT GROUP, Inc. 2792 COUNTRY WAY CLEARWATER, FLORIDA 34623 (813) 724-6100		
DESIGNER LMA Landon, Moore & Associates, Inc. CIVIL & ENVIRONMENTAL ENGINEERS PLANNERS - SURVEYORS 3162 U.S. 19 NORTH Palm Harbor, Florida 34684 Phone (813) 789-5300 FAX (813) 787-4354		