

RECORD DRAWING CERTIFICATION

THESE RECORD DOCUMENTS HAVE BEEN PREPARED ON INFORMATION PROVIDED BY OTHERS. THE DESIGN PROFESSIONAL HAS NOT VERIFIED THE ACCURACY AND/OR COMPLETENESS OF THIS INFORMATION, AND SHALL NOT BE RESPONSIBLE FOR ANY ERRORS OR OMISSIONS WHICH MAY BE INCORPORATED HEREIN AS A RESULT. THE TERM "CERTIFICATION" AS USED HEREIN SHALL BE AS SET FORTH IN STATE RULE 61G15-18-01(4).

SECTION 26, TOWNSHIP 28 SOUTH, RANGE 15 EAST
City of Dunedin, Florida

GRAPHIC SCALE




SEE SHEET NO. 3 FOR LEGEND & NOTES

Existing	Proposed
—	— FM —
—	— SANITARY SEWER —
—	— SANITARY MANHOLE —
—	— SANITARY SERVICE —
—	— WATER MAIN —
—	— FIRE HYDRANT ASSEMBLY —
—	— GATE VALVE ASSEMBLY —
—	— WATER METER —
—	— STORM SEWER —
—	— STORM INLET —
—	— GRATE INLET —
—	— FLARED END SECTION —
—	— LITTORAL SHELF AREA —
—	— UNSTRUCTURED AND STABILIZED ACCESS —
—	— SILT FENCE —

TREE LEGEND:

- OAK
- ◇ AUSTRALIAN PINE
- ◇ CAMPHOR
- ▲ CHERRY
- CHINABERRY
- CHERRY LAUREL
- ★ MAPLE
- ★ MYRTLE
- ★ PALM
- △ PINE
- △ TALLOWTREE
- TREE, TYPE UNKNOWN

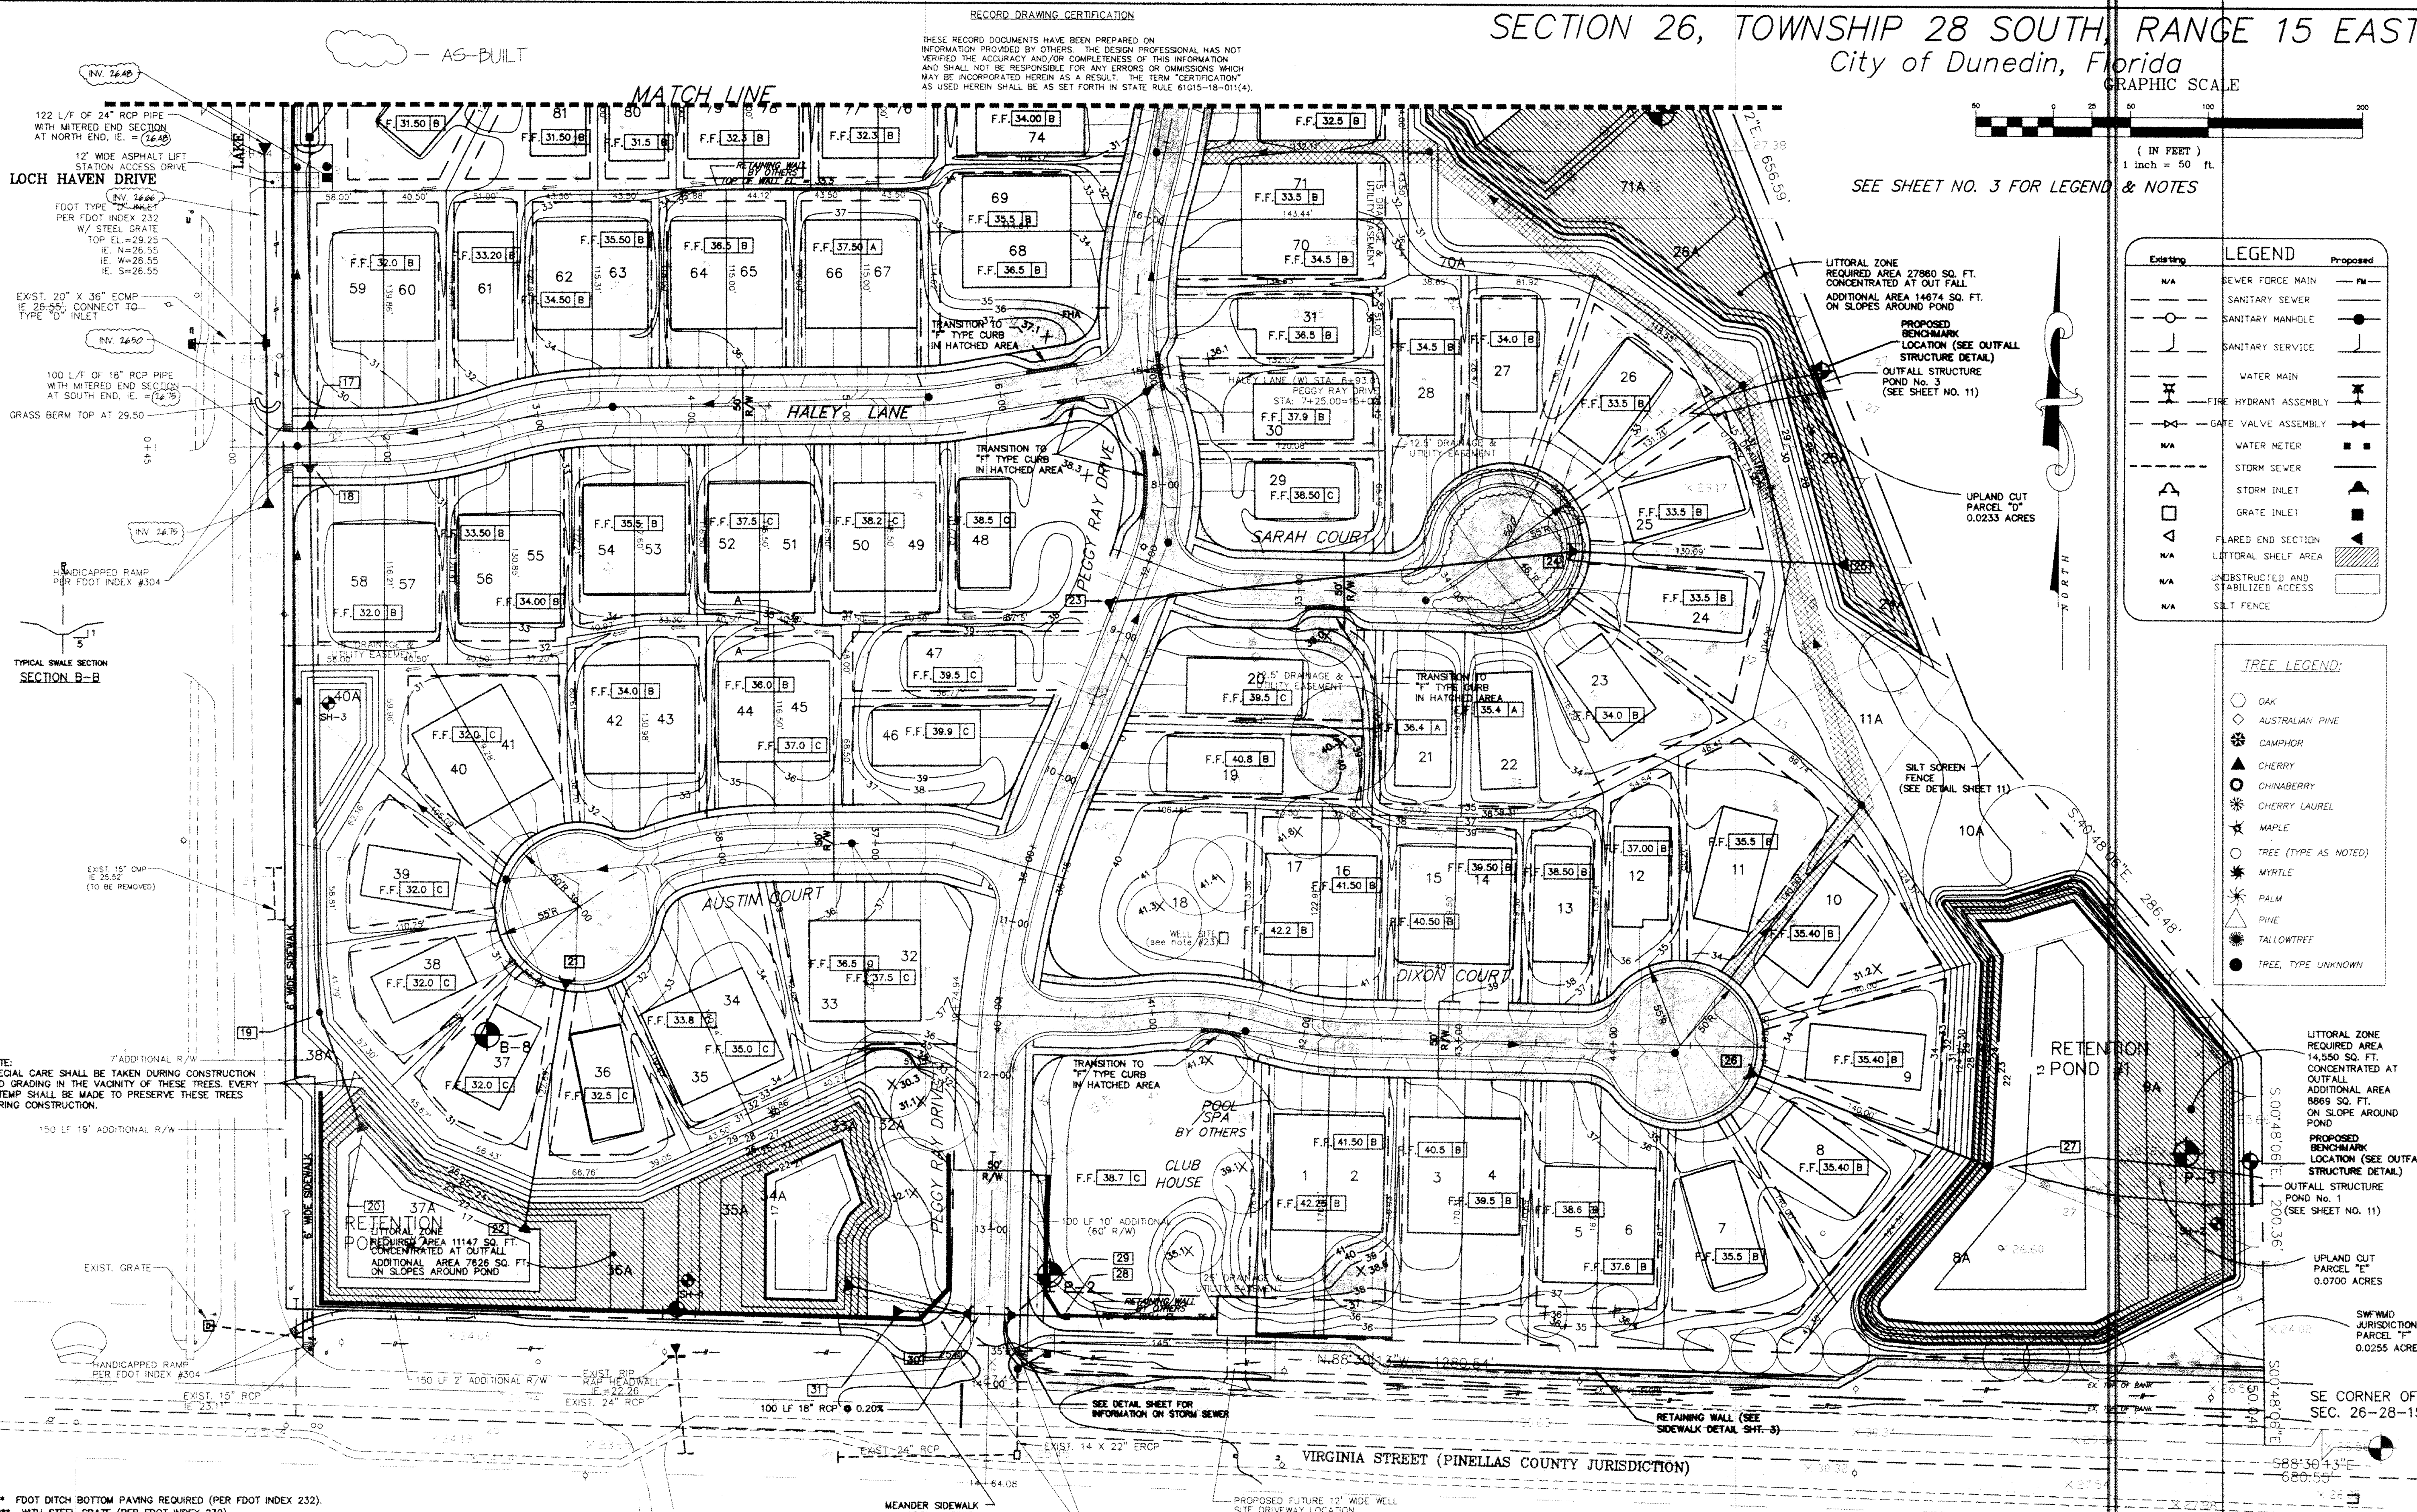

STRUCTURE NO.	STATION	LT/RT	TYPE	I.E. IN	I.E. OUT	E.P./RIM EL.	FROM NO.	TO NO.	SIZE RCP	LENGTH (FT.)	SLOPE %
16	1+50.44	200.06' LT	D ***	26.02 (24.87)	26.00 (27.94)	26.00 (27.94)	16	17	24"	186	0.50
17	1+50.44	14.75' LT	2	24.08 (24.87)	24.06 (30.24)	24.06 (30.24)	16	18	24"	30	0.30
18	1+50.00	14.75' RT	2	24.08 (24.87)	24.06 (24.94)	24.06 (24.94)	17	19	30"	335	0.30
19	1+55.13	365.47' RT	MH	24.00 (24.87)	23.97 (25.75)	23.97 (25.75)	18	20	30"	93	0.30
20	1+80.76	437.53' RT	24 FES	25.69 (25.50)	25.69 (25.50)	25.69 (25.50)	19	21	18"	160	0.50
21	39+43.15	29.98' LT	2	26.00 (24.86)	26.00 (24.86)	26.00 (24.86)	21	23	18"	160	0.50
22	8+85.00	14.75' RT	2	24.14	24.14	24.14	22	24	15"	300	3.30
23	34+76.96	28.31' RT	2	24.14	24.14	24.14	23	25	18"	180	0.50
24			18 FES	23.24 (23.25)			24				

STRUCTURE NO.	STATION	LT/RT	TYPE	I.E. IN	I.E. OUT	E.P./RIM EL.	FROM NO.	TO NO.	SIZE RCP	LENGTH (FT.)	SLOPE %
26	44+89.76	16.92' RT	2	26.00 (25.97)	26.00 (25.97)	26.00 (25.97)	26	27	18"	160	1.25
27			18 FES	24.00 (23.99)			27				
28	13+55.42	41.12' LT	D ***	26.00 (26.24)	26.00 (26.24)	26.00 (26.24)	28	29	18"	26	0.20
29	13+55.05	14.75' LT	2	26.05 (26.04)	26.05 (26.04)	26.05 (26.04)	28	30	18"	30	0.20
30	13+55.05	14.75' RT	2	26.79 (26.52)	26.79 (26.52)	26.79 (26.52)	29	31	24"	44	0.20
31	13+54.04	58.87' RT	18 FES	26.60 (25.7)			30				

PAVING, GRADING, & DRAINAGE PLAN SOUTH

VIRGINIA CROSSING

HIGHMARK DEVELOPMENT GROUP, Inc.

1430 VIRGINIA STREET
DUNEDIN, FLORIDA 34698 Ph. (813) 735-6100

LMA
Landon, Moore & Associates, Inc.
CIVIL & ENVIRONMENTAL ENGINEERS
PLANNERS - SURVEYORS
31622 U.S. 19 NORTH Palm Harbor, Florida 34684
Phone (813) 789-5800 FAX (813) 767-4394

SHEET 4 OF 17