
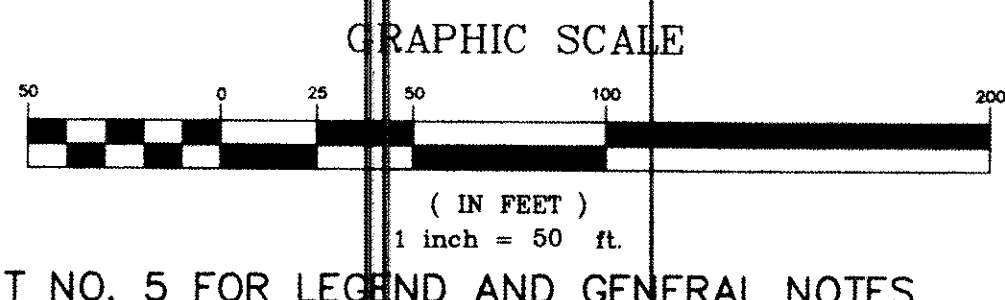


SECTION 26, TOWNSHIP 28 SOUTH, RANGE 15 EAST  
City of Dunedin, Florida

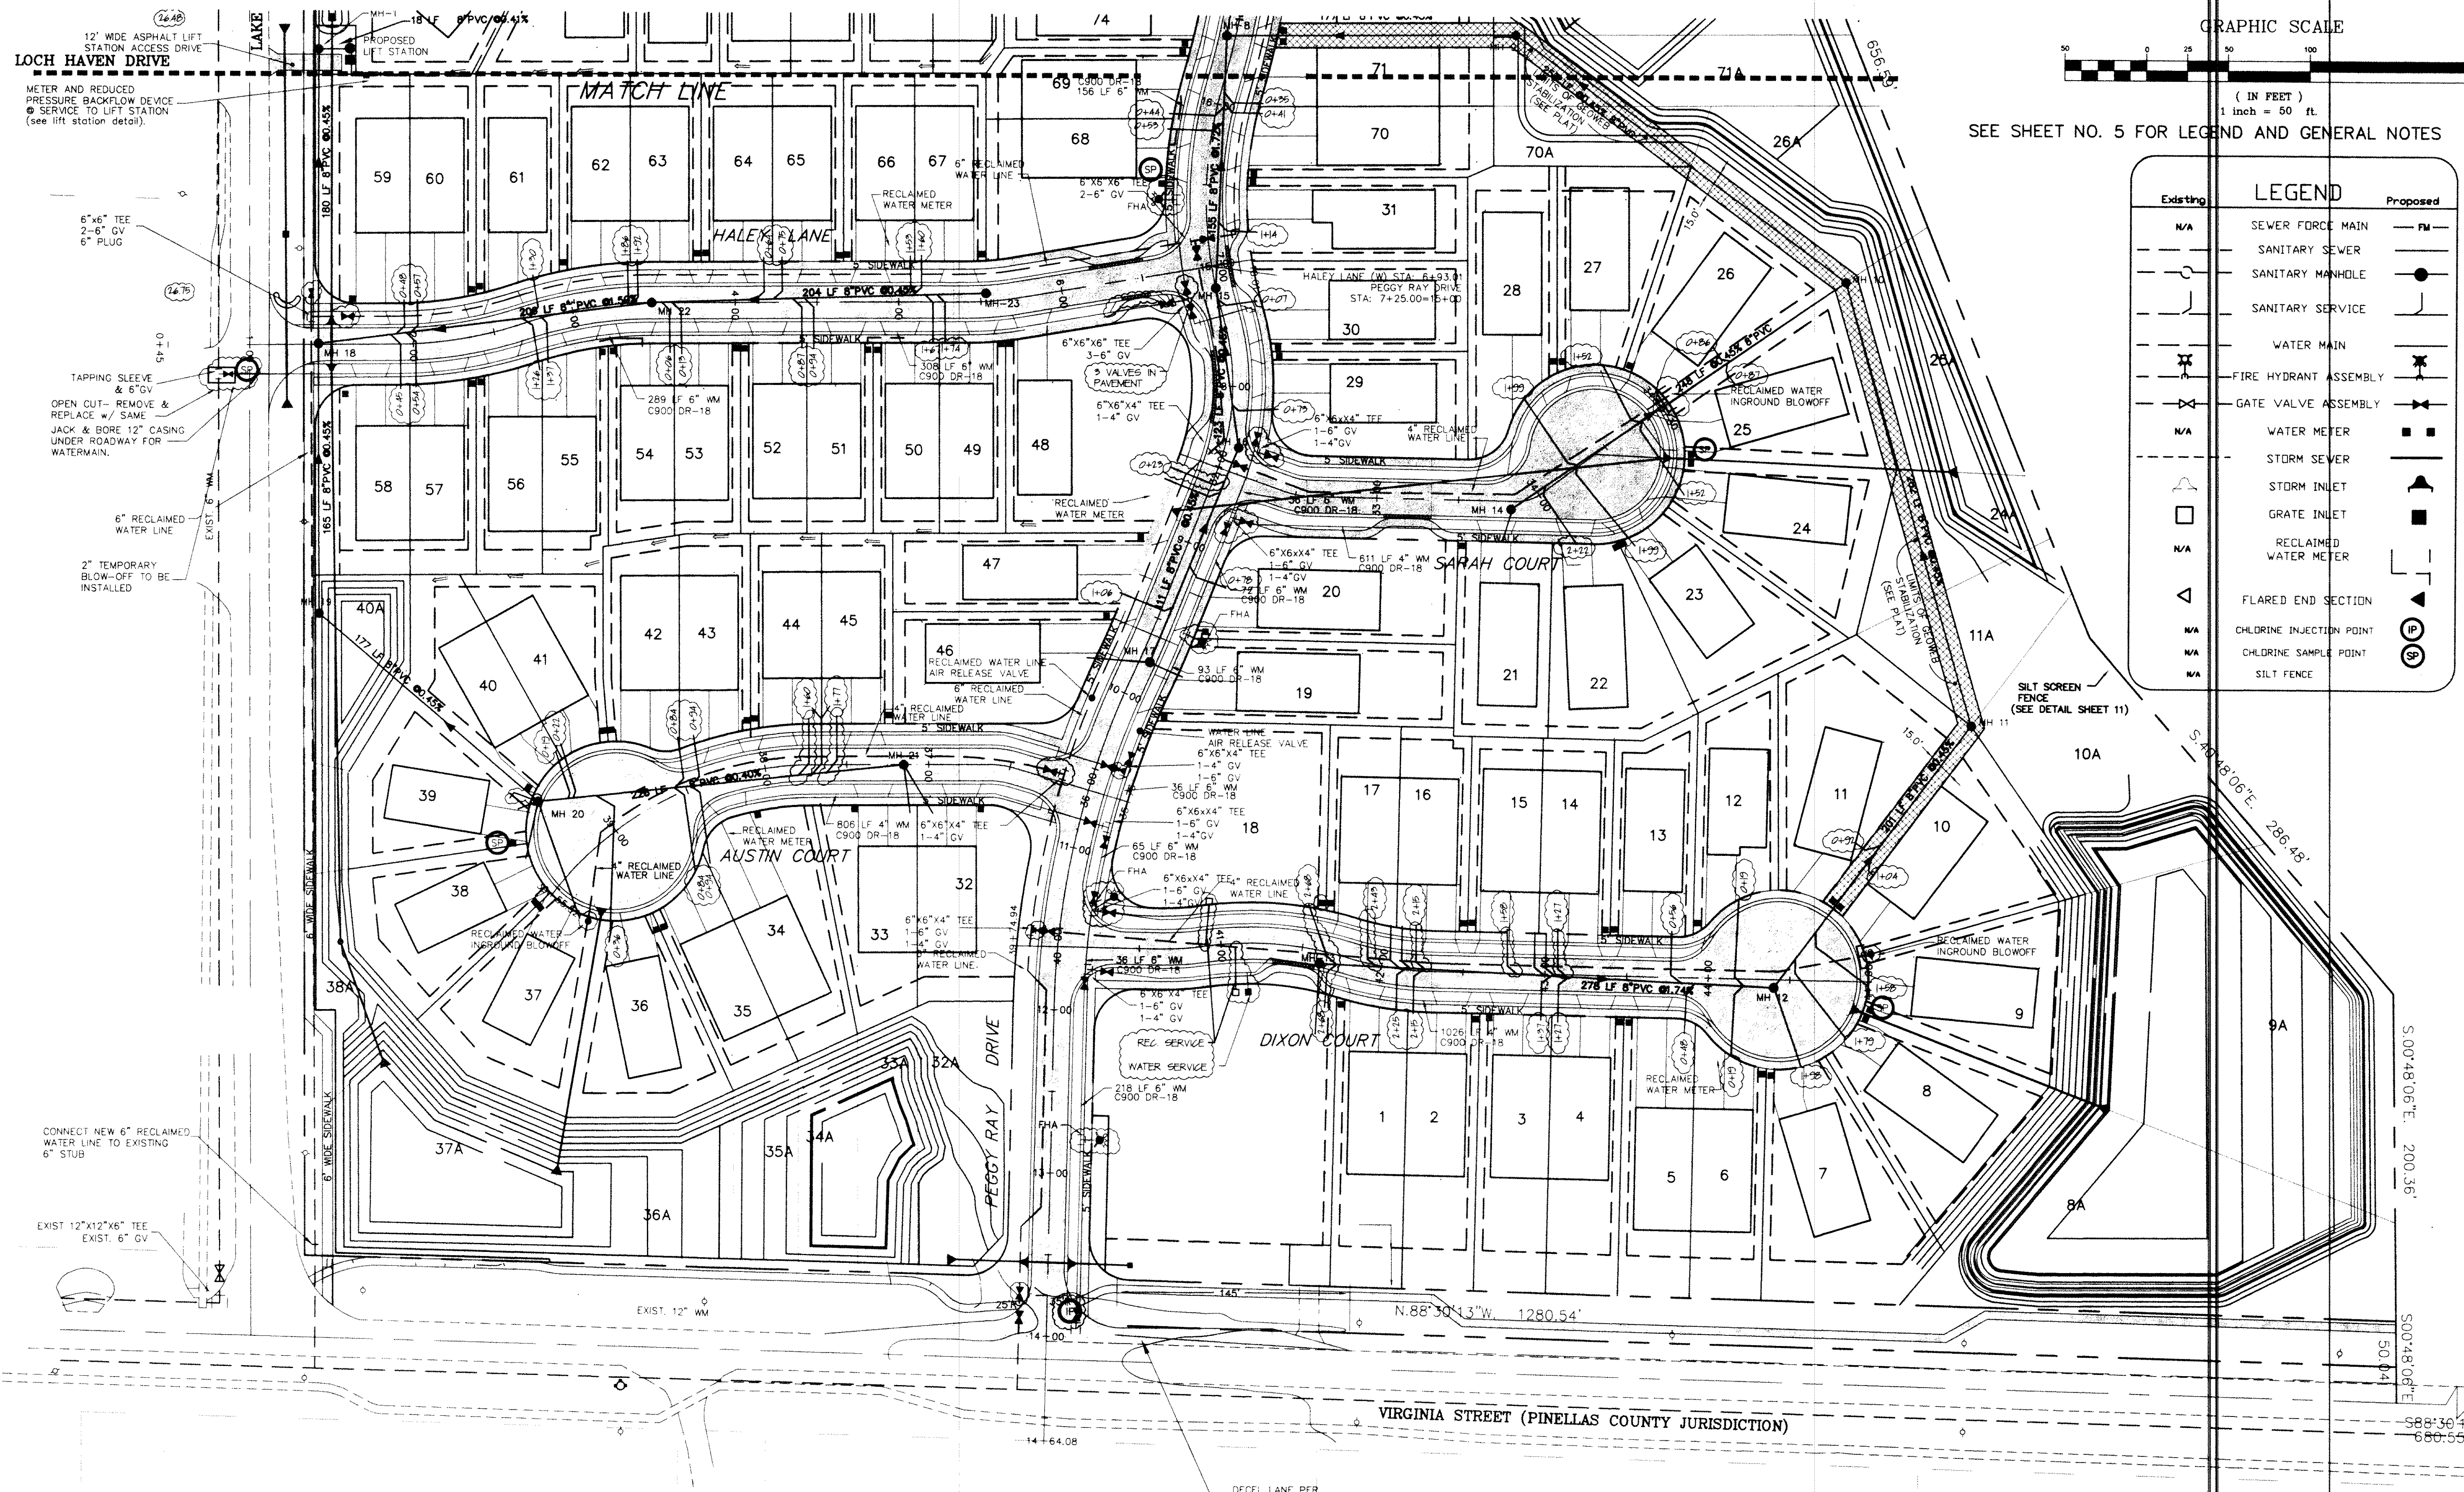

| Existing | Proposed                 |
|----------|--------------------------|
| N/A      | SEWER FORCE MAIN         |
| N/A      | SANITARY SEWER           |
| N/A      | SANITARY MANHOLE         |
| N/A      | SANITARY SERVICE         |
| N/A      | WATER MAIN               |
| N/A      | FIRE HYDRANT ASSEMBLY    |
| N/A      | GATE VALVE ASSEMBLY      |
| N/A      | WATER METER              |
| N/A      | STORM SEWER              |
| N/A      | STORM INLET              |
| N/A      | GRATE INLET              |
| N/A      | RECLAIMED WATER METER    |
| N/A      | FLARED END SECTION       |
| N/A      | CHLORINE INJECTION POINT |
| N/A      | CHLORINE SAMPLE POINT    |
| N/A      | SILT FENCE               |

AS-BUILT INFORMATION ADDED  
03-22-99 AS-BUILT INFORMATION ADDED  
06-09-98 REVISED PER PINELLAS COUNTY COMMENTS DATED 03-31-98  
05-14-98 REVISED PER CITY OF DUNEDIN COMMENTS DATED 05-08-98  
05-05-98 REVISED PER CITY OF DUNEDIN COMMENTS DATED 05-04-98  
04-27-98 REVISED PER CITY OF DUNEDIN COMMENTS DATED 04-16-98  
04-01-98 REVISED PER CITY OF DUNEDIN COMMENTS DATED 03-24-98

Scale: 1"=50'  
JCL  
Design: JCL  
Drawn: JWR  
Checked: JWR  
Date: 04-02-98  
Job No: 217-04.200  
f:\dwgs\217-04\wat sew.dwg

VIRGINIA CROSSING  
HIGHMARK DEVELOPMENT GROUP, Inc.  
1430 VIRGINIA STREET  
DUNEDIN, FLORIDA 34698 PH. (813) 735-6100

**LMA**  
London, Moore & Associates, Inc.  
CIVIL & ENVIRONMENTAL ENGINEERS  
PLANNERS - SURVEYORS  
3622 U.S. 19 NORTH Palm Harbor, Florida 34684  
Phone (813) 769-5000 FAX (813) 767-4394

SHEET  
6  
OF 17

WATER, RECLAIMED WATER & SANITARY SEWER PLAN (SOUTH)