



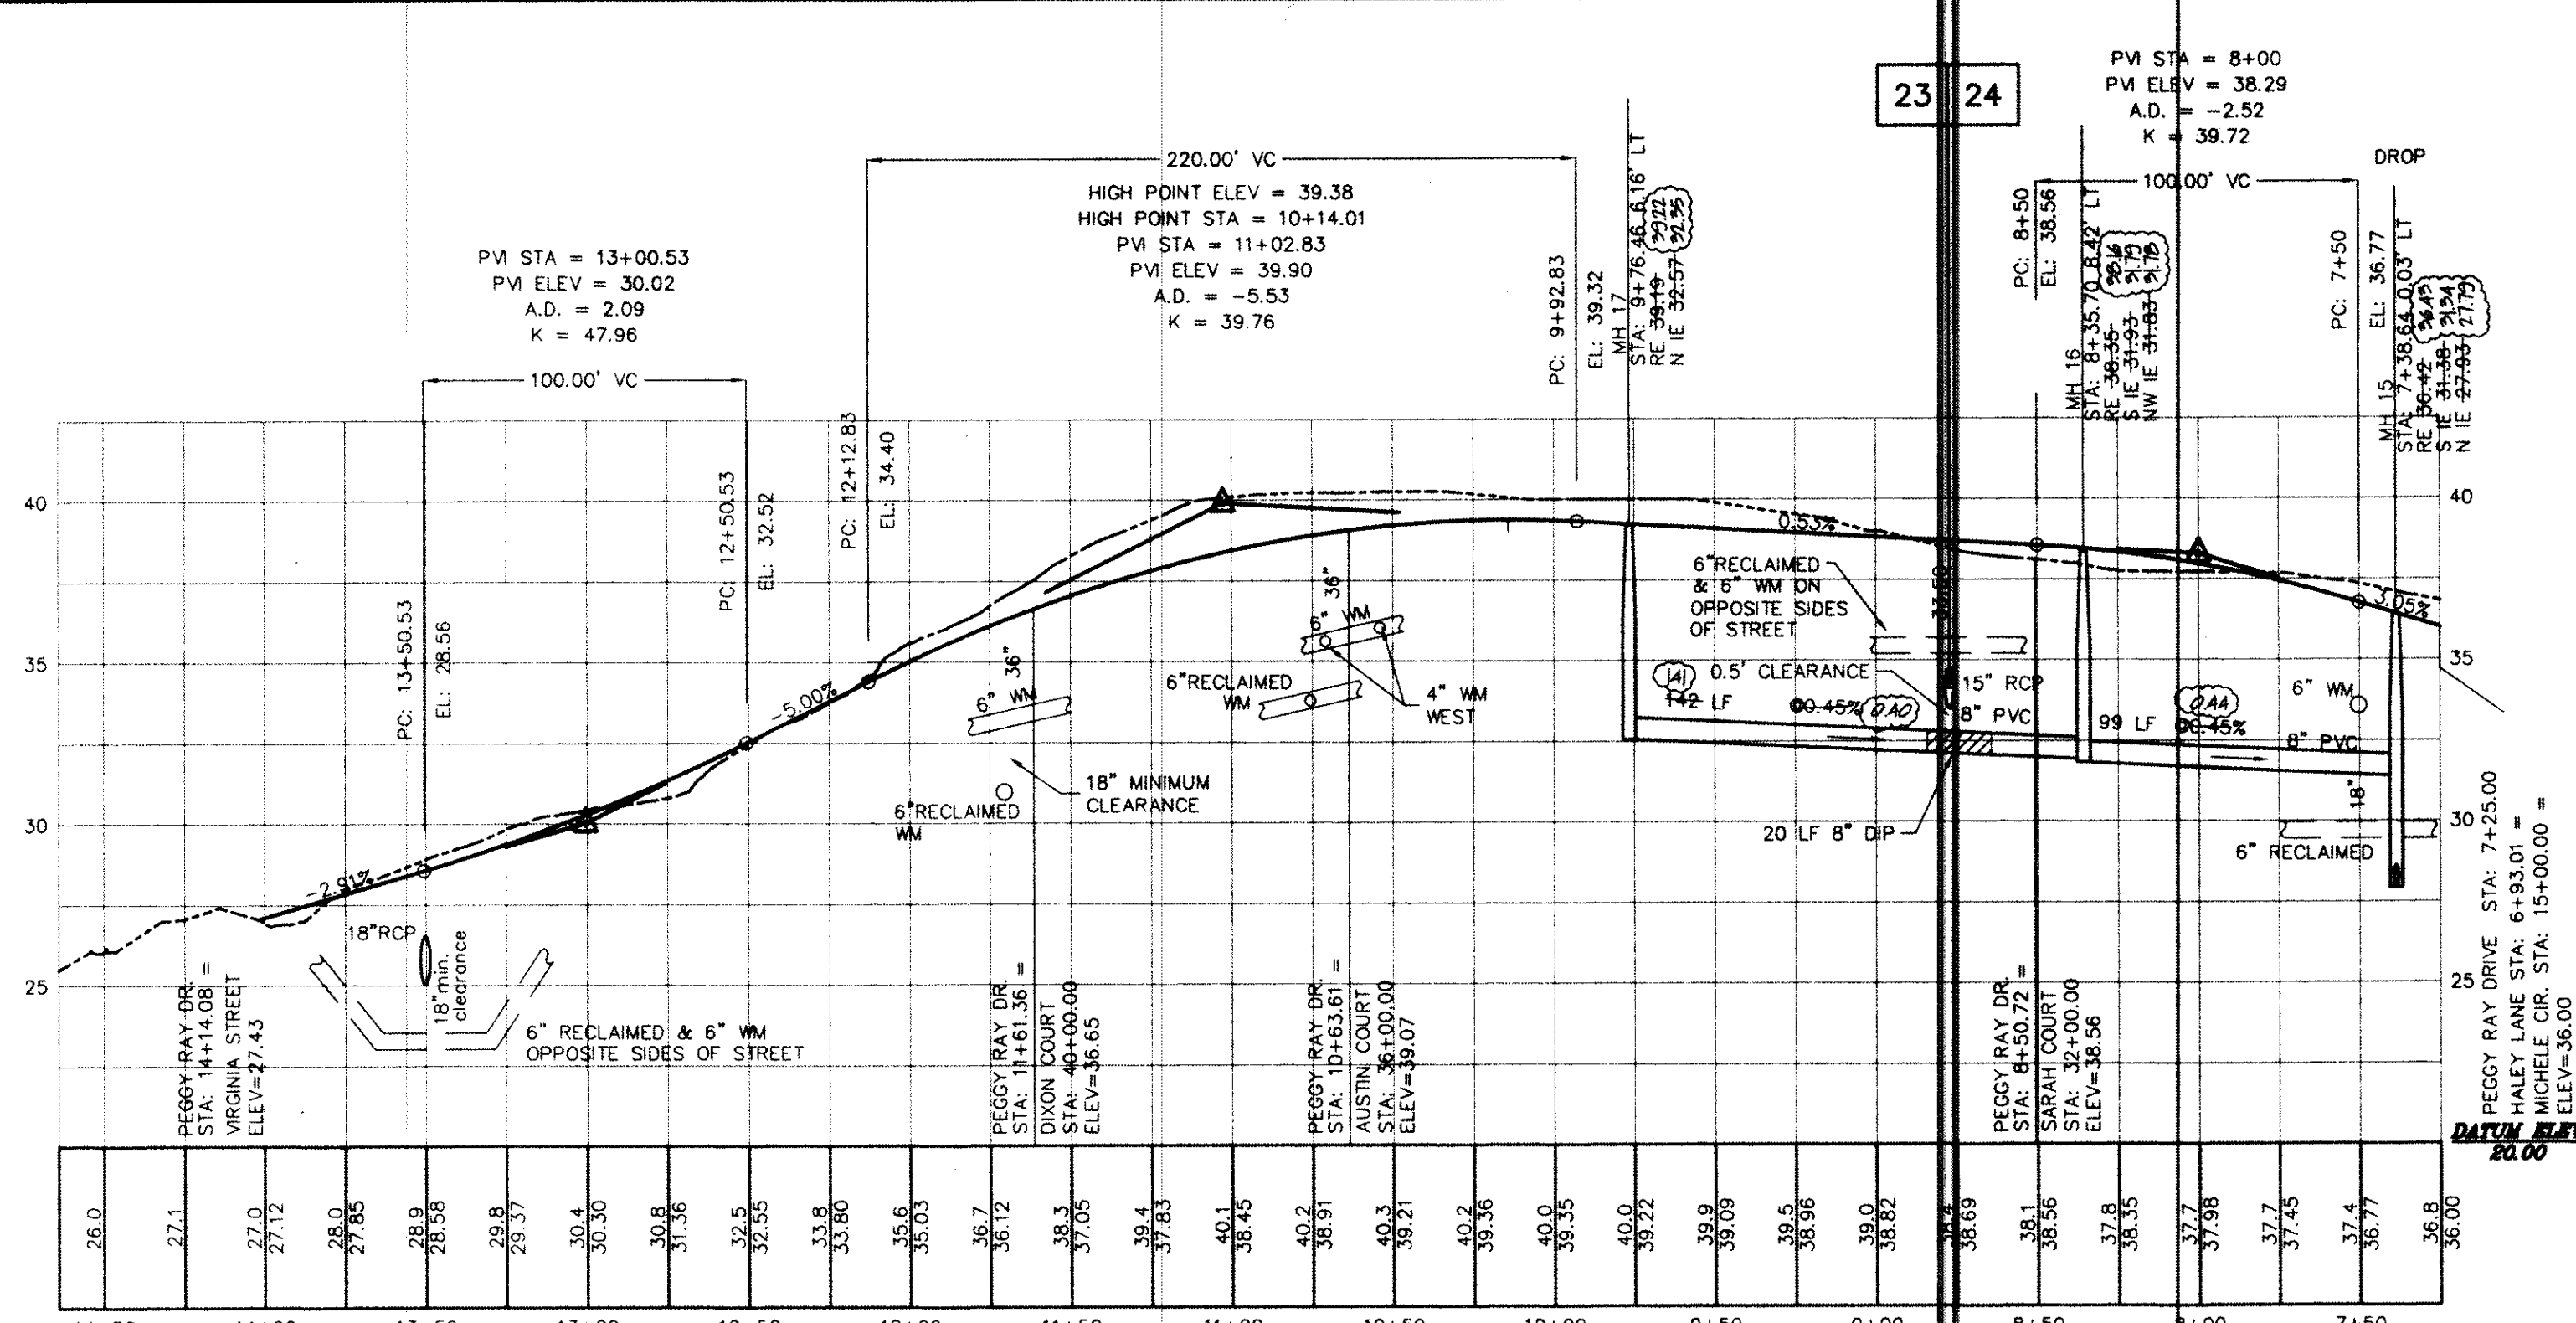

PEGGY RAY DRIVE

RECORD DRAWING CERTIFICATION

THESE RECORD DOCUMENTS HAVE BEEN PREPARED ON INFORMATION PROVIDED BY OTHERS. THE DESIGN PROFESSIONAL HAS NOT VERIFIED THE ACCURACY AND/OR COMPLETENESS OF THIS INFORMATION AND SHALL NOT BE RESPONSIBLE FOR ANY ERRORS OR OMISSIONS WHICH MAY BE INCORPORATED HEREIN AS A RESULT. THE TERM "CERTIFICATION" AS USED HEREIN SHALL BE AS SET FORTH IN STATE RULE 61G15-18-011(4).

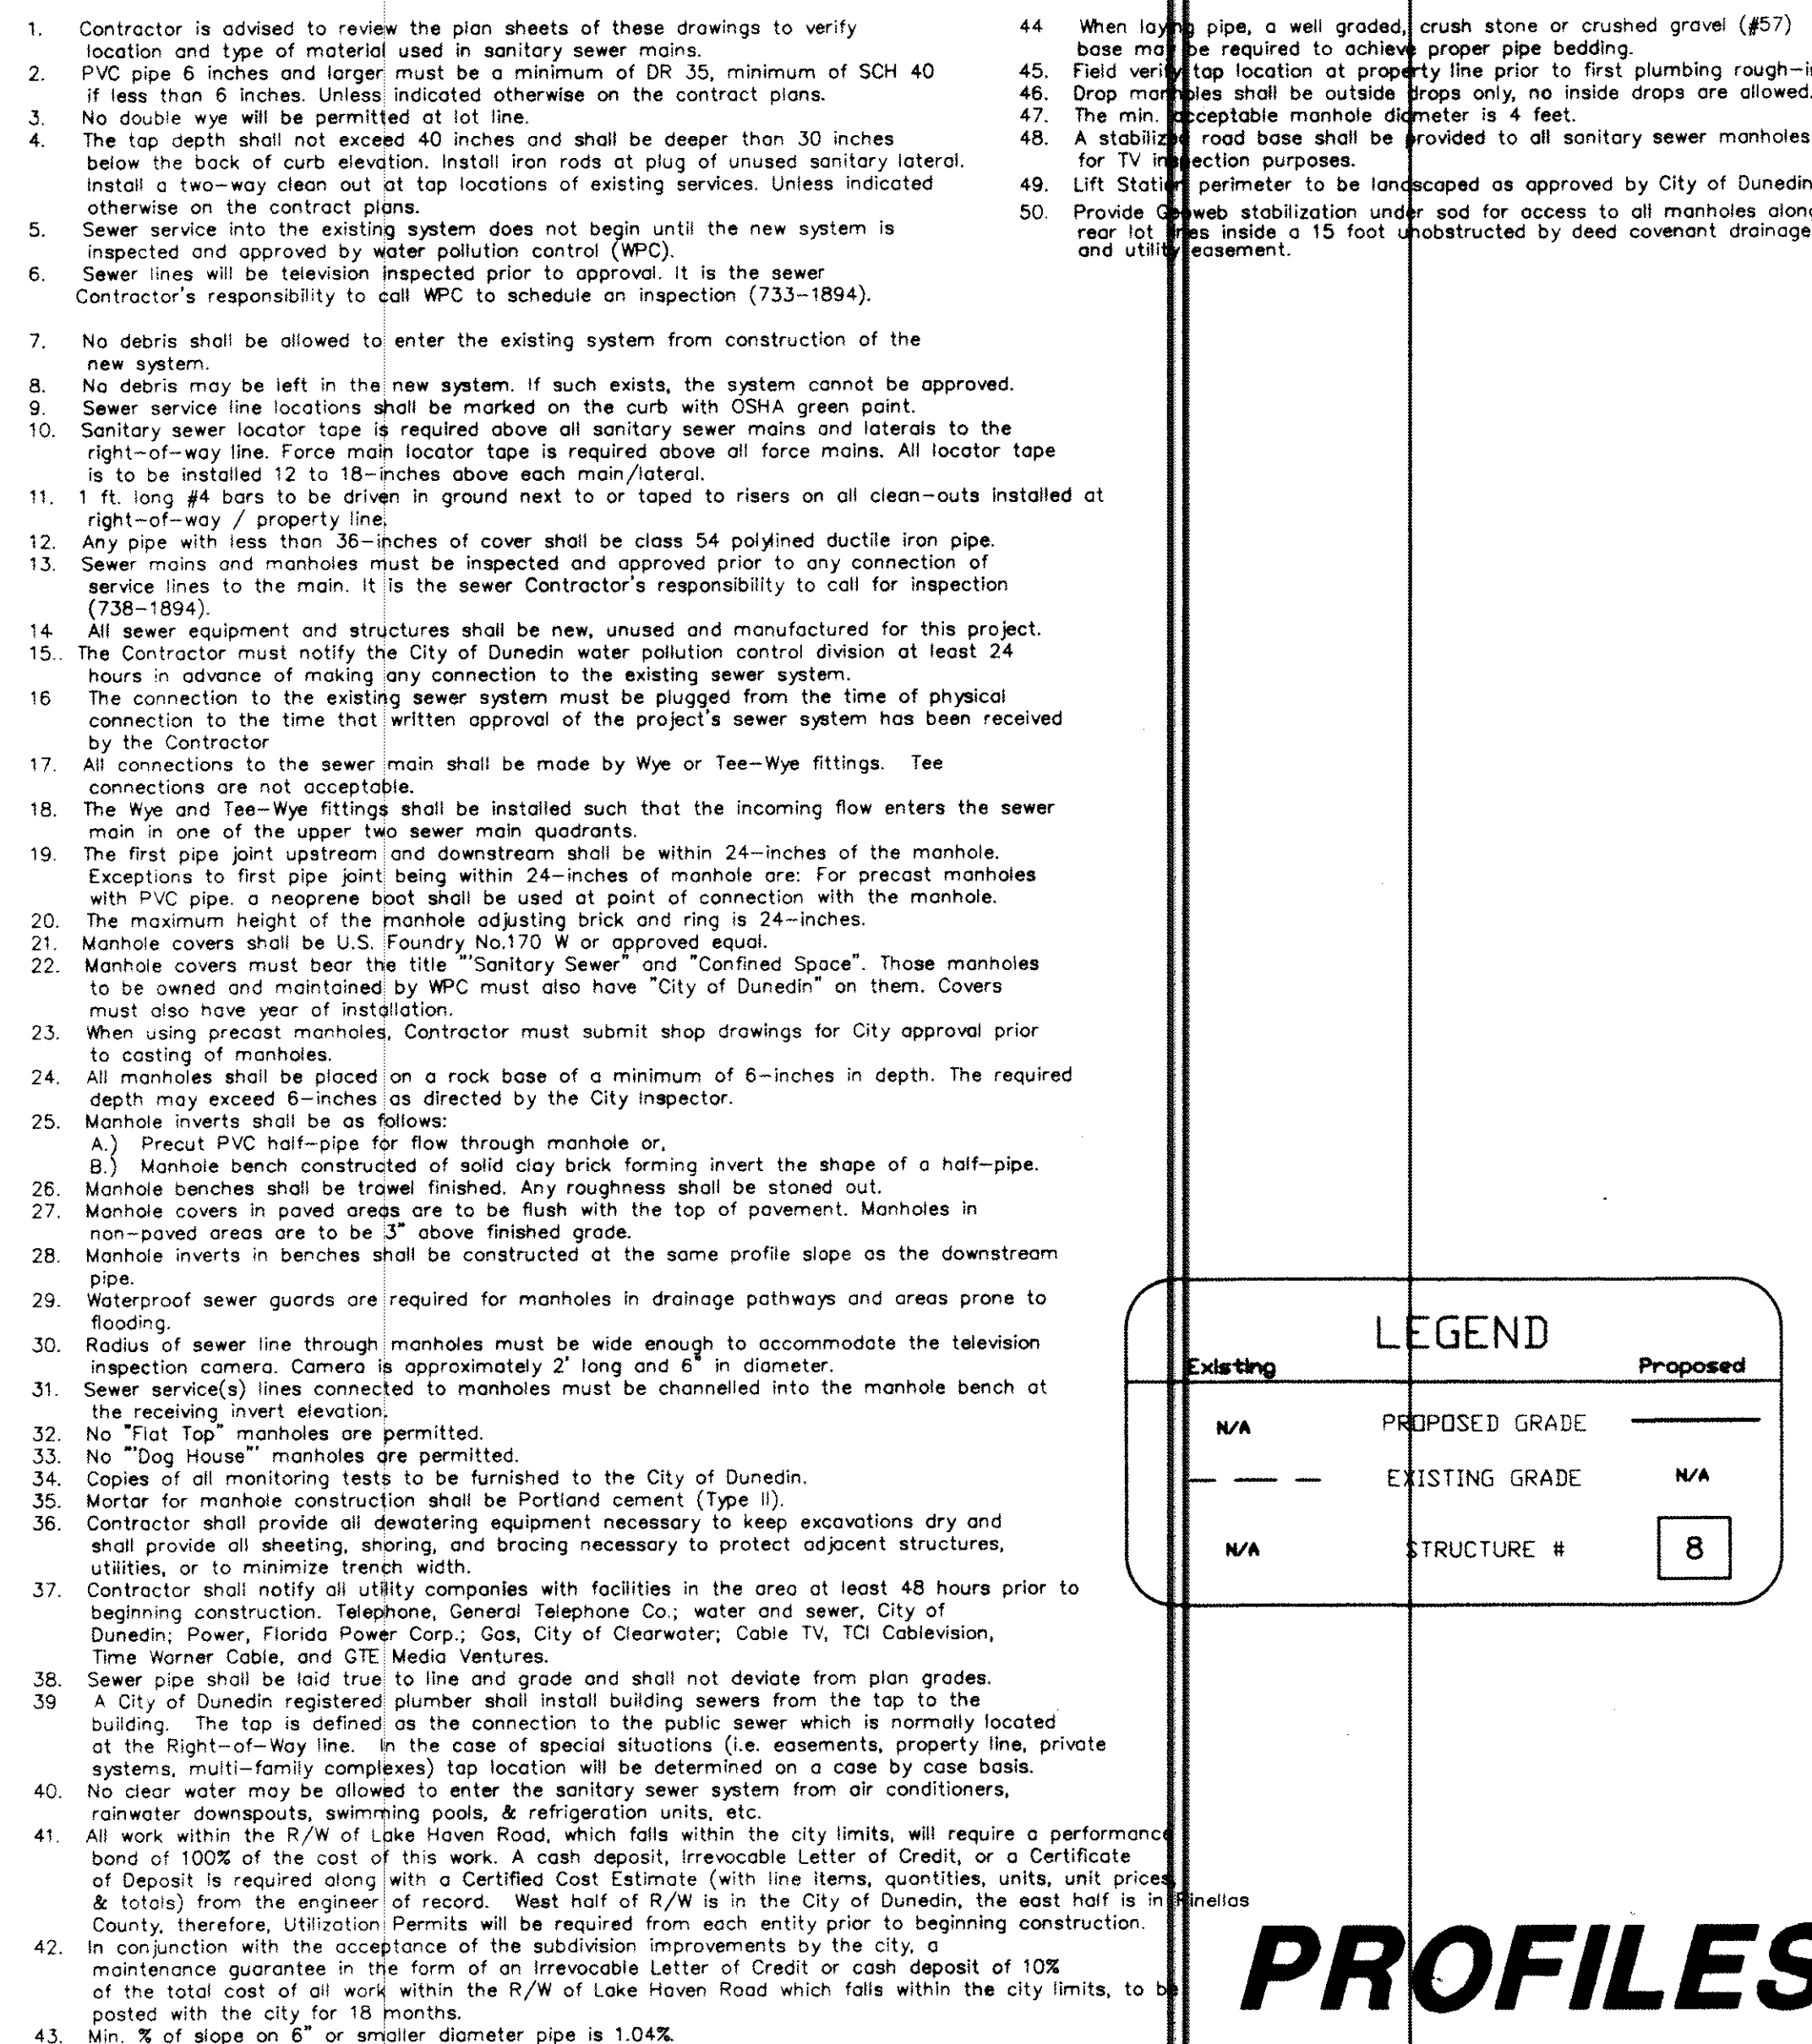

VIRGINIA CROSSING

HIGHMARK DEVELOPMENT GROUP, Inc.
2792 COUNTRY WAY

LMA
 London, Morse & Associates, Inc.
 CIVIL & ENVIRONMENTAL ENGINEERS
 PLANNERS - SURVEYORS

7
OF 17