


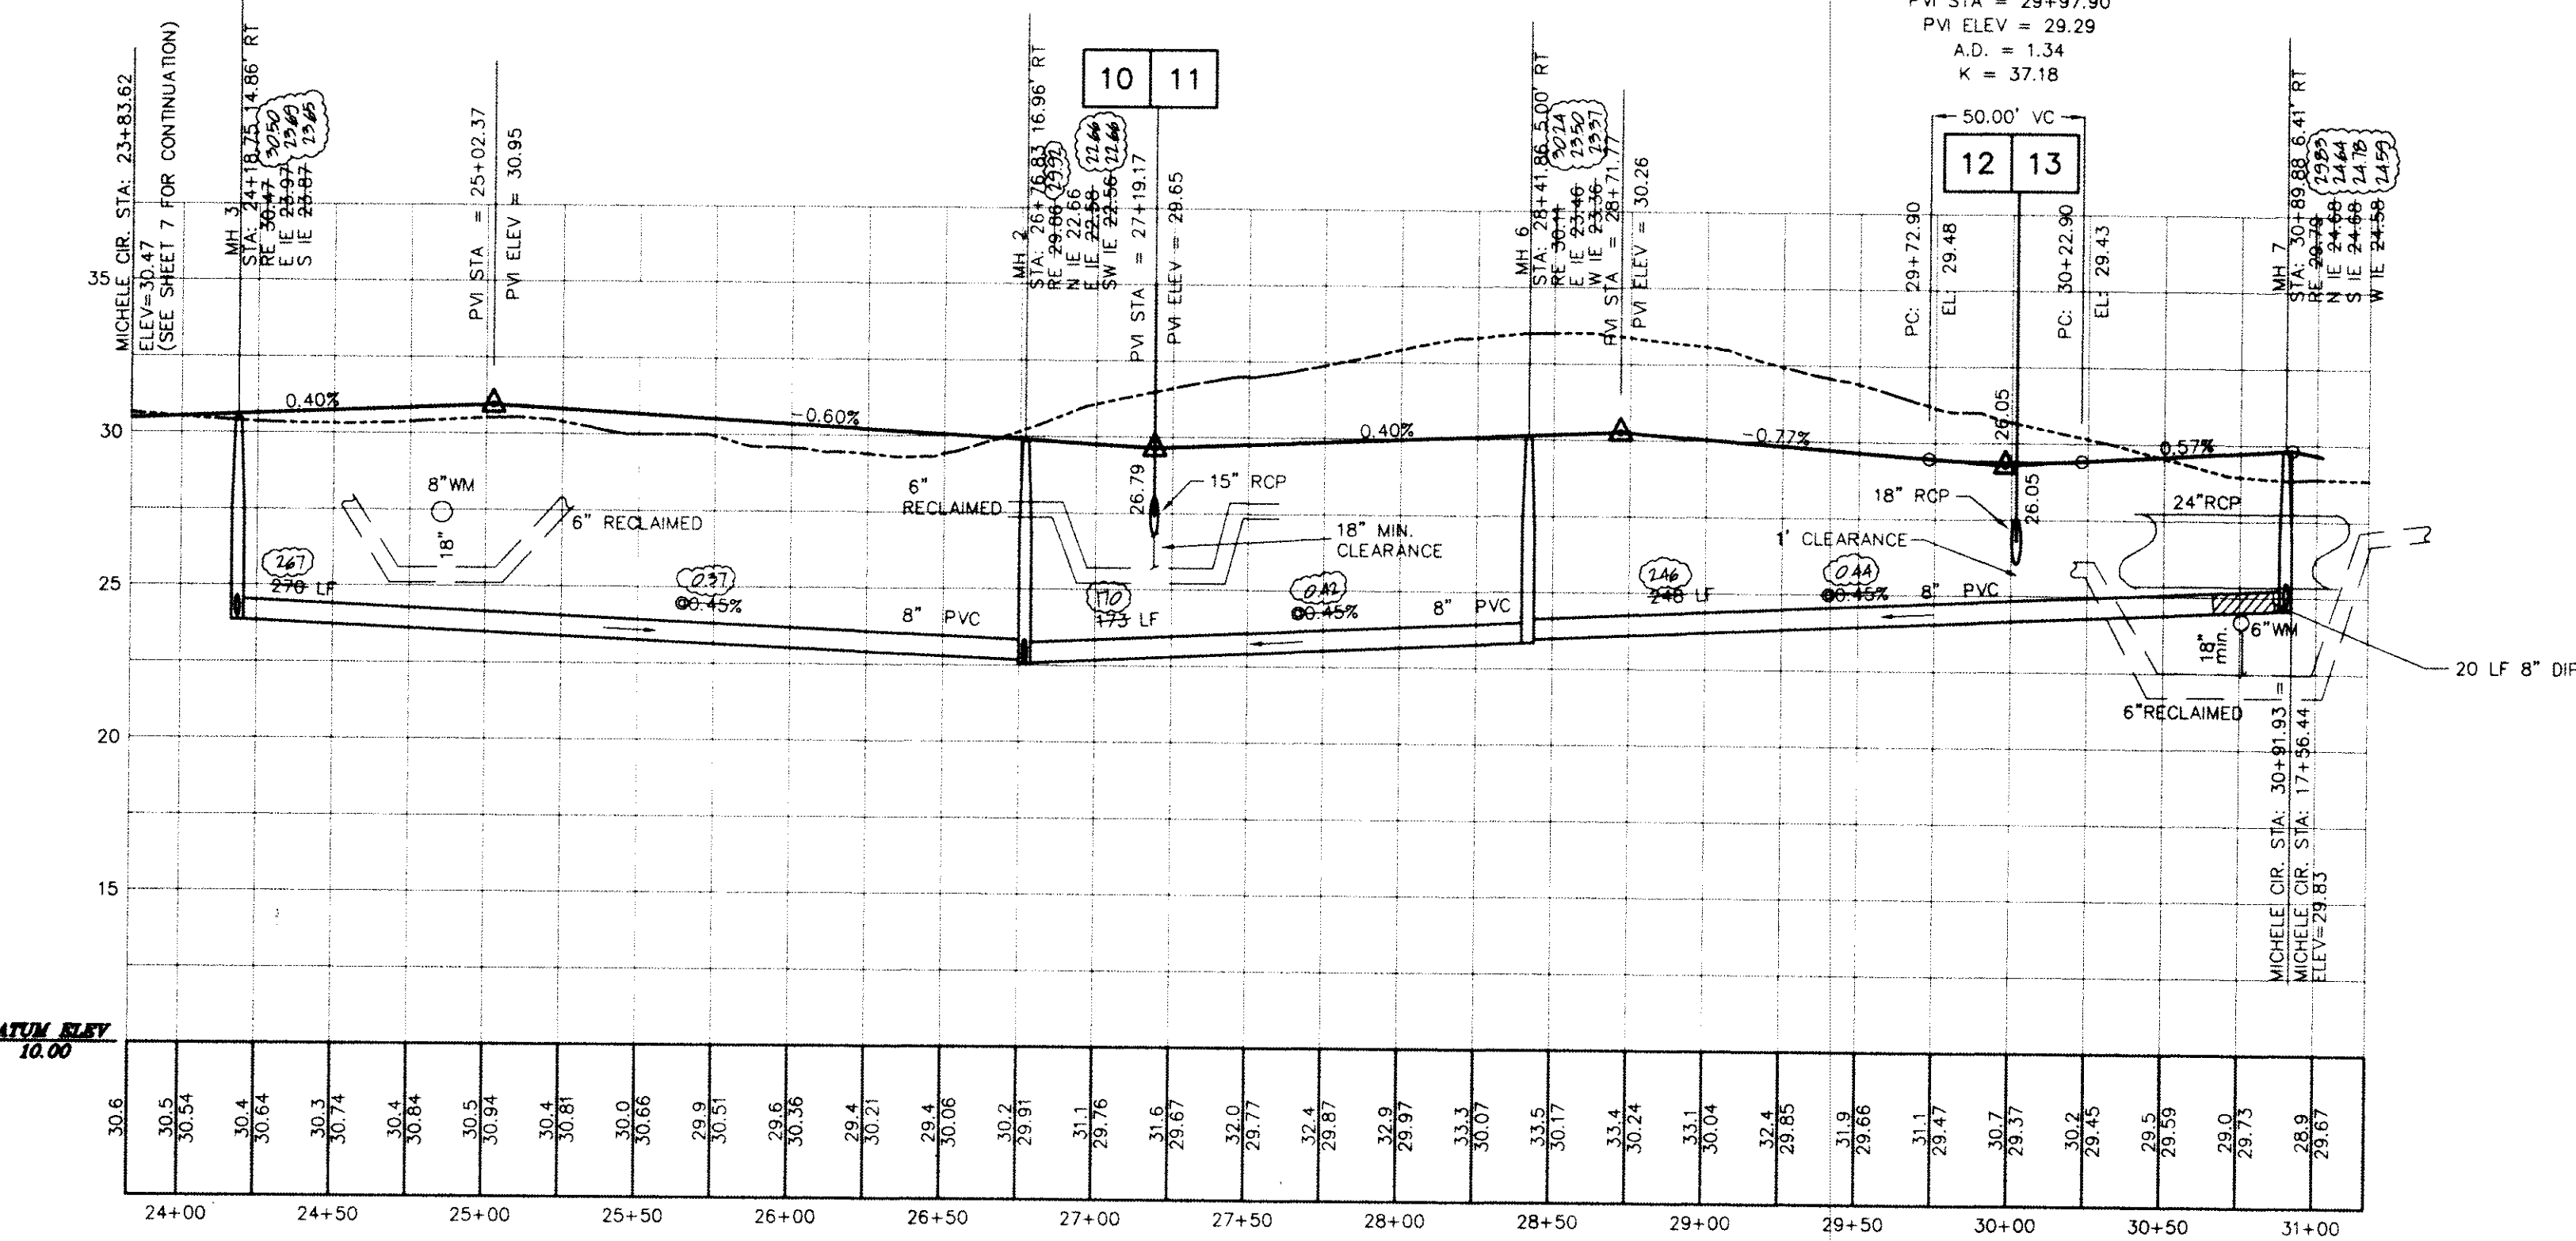
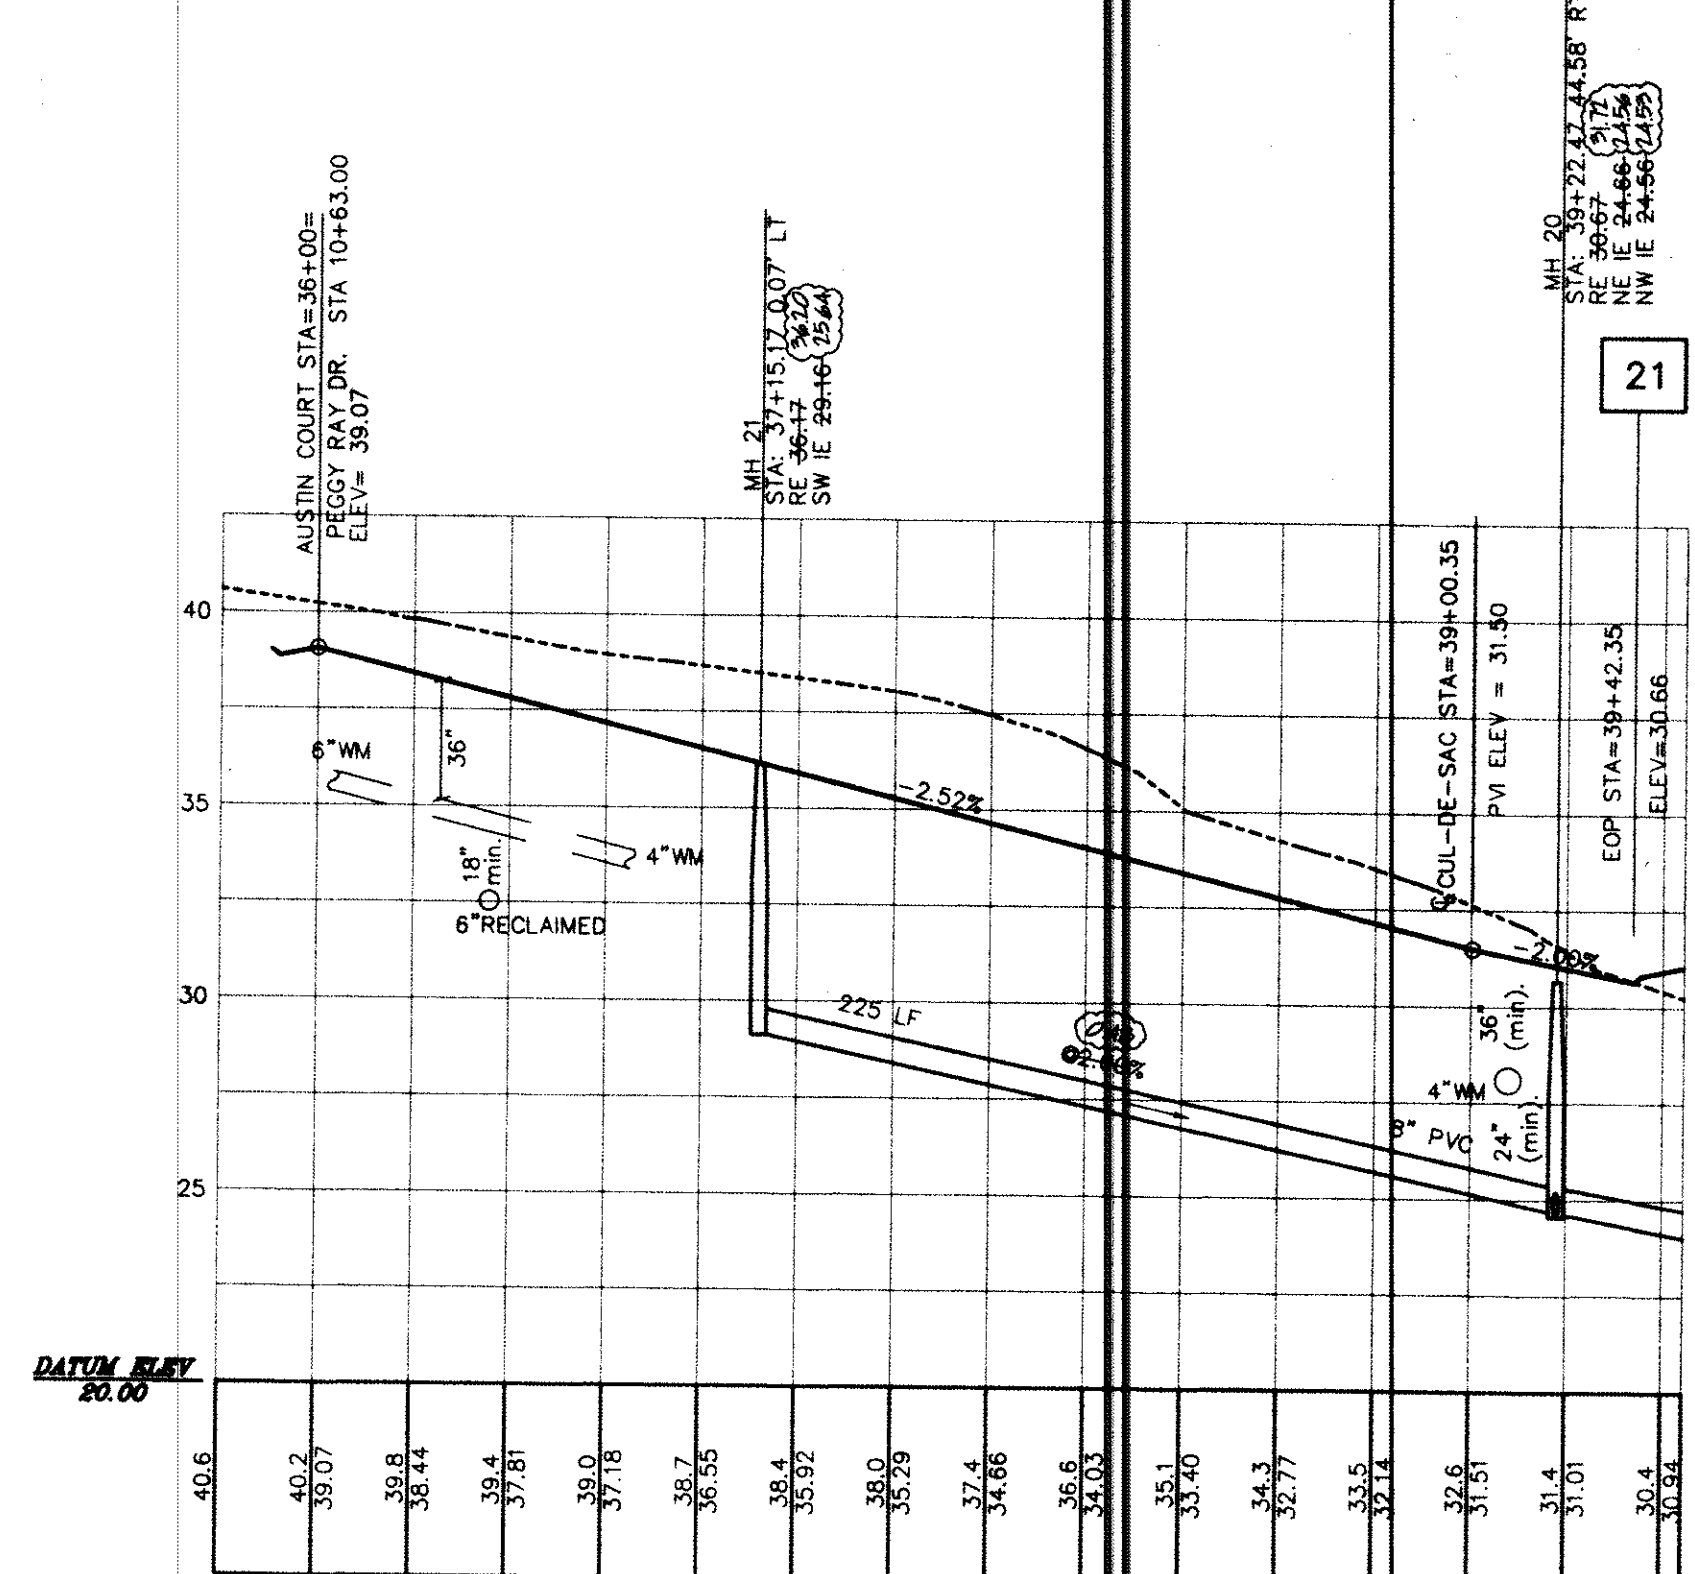
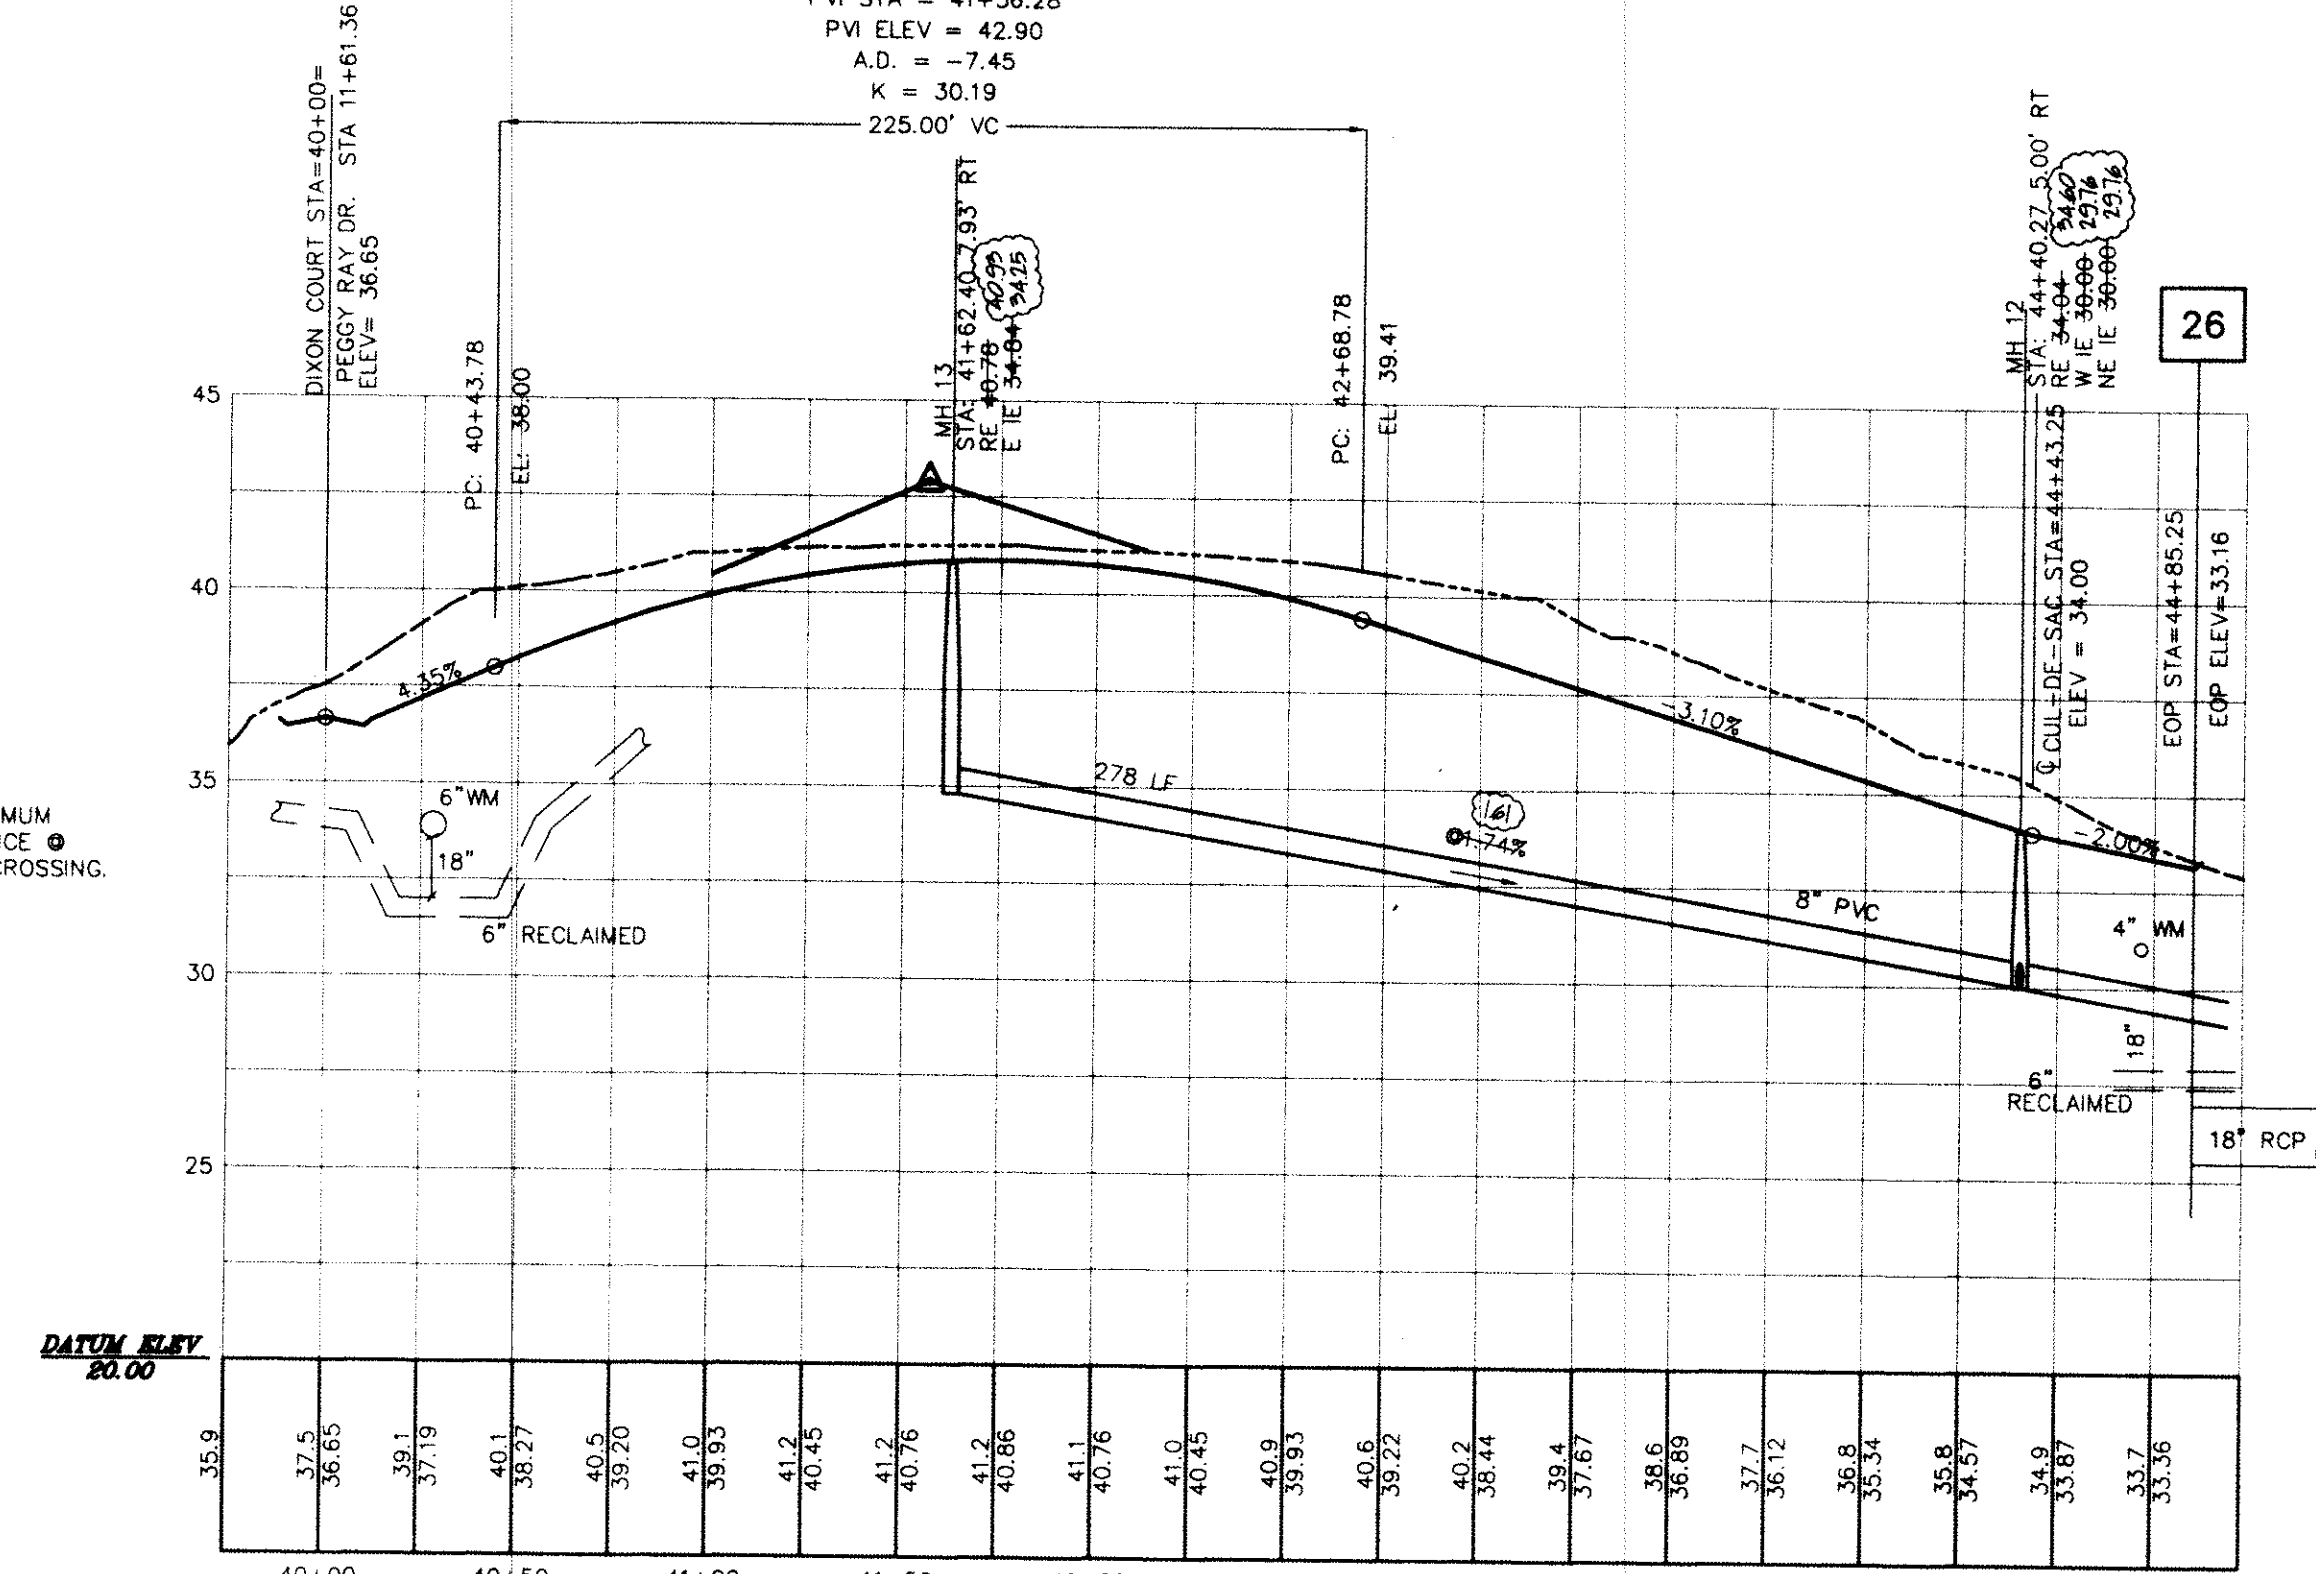
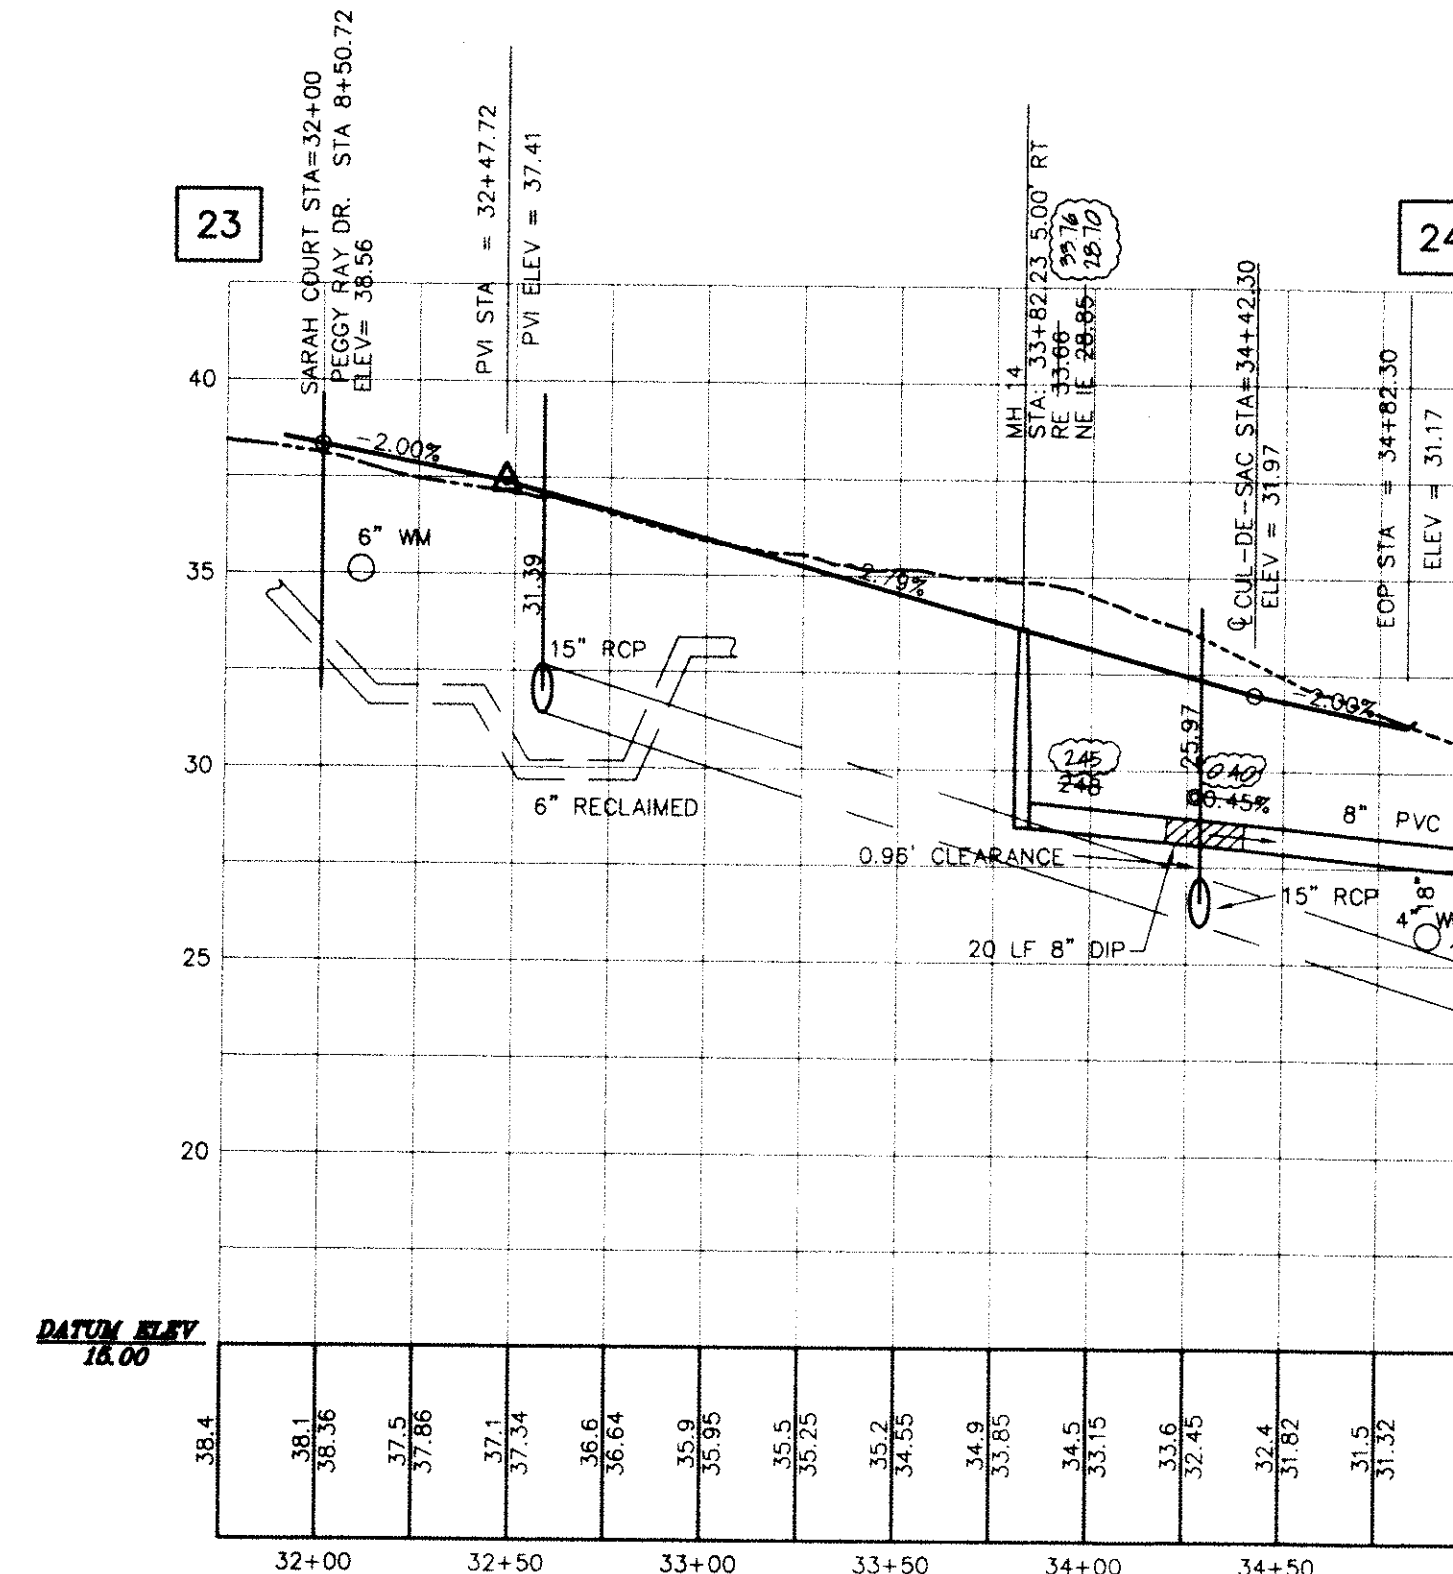


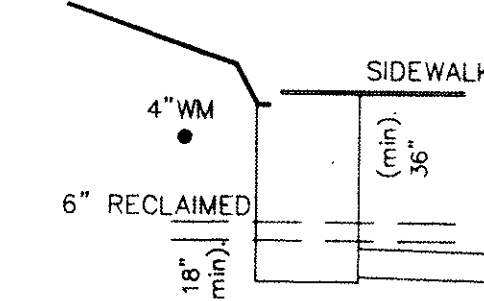

STORM STRUCTURE NO.26

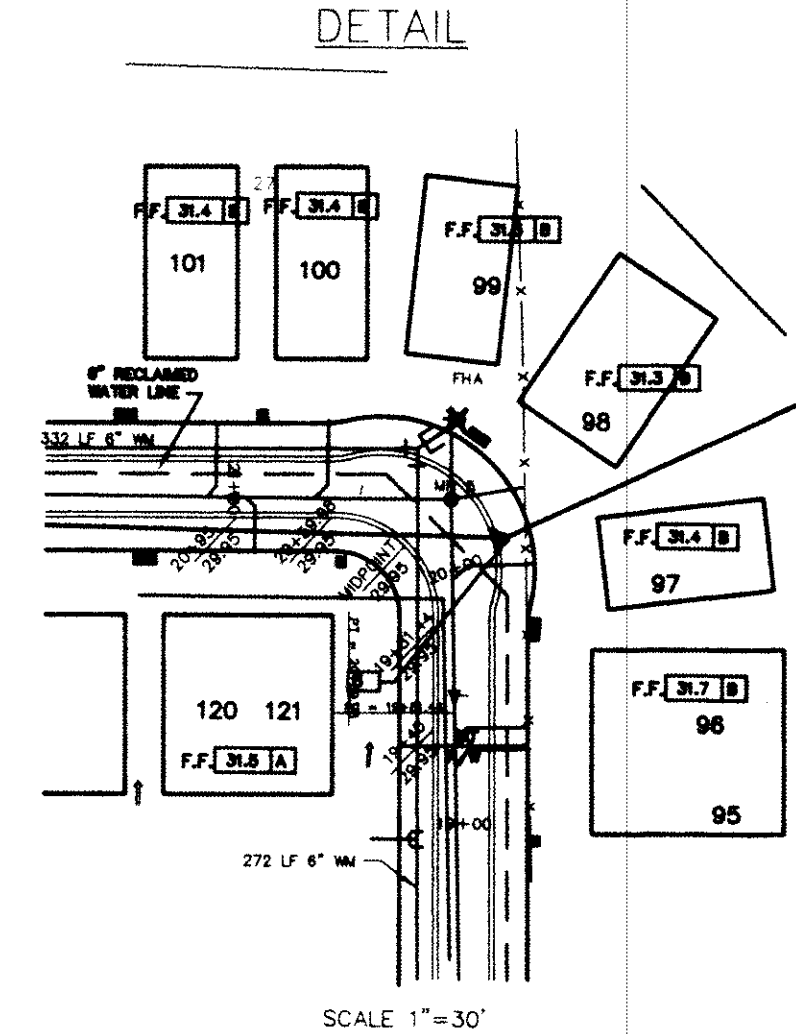

STORM STRUCTURE NO.21

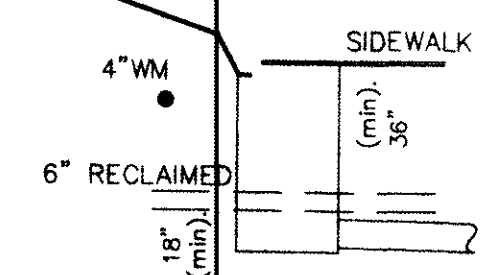

RECORD DRAWING CERTIFICATION

THESE RECORD DOCUMENTS HAVE BEEN PREPARED ON INFORMATION PROVIDED BY OTHERS. THE DESIGN PROFESSIONAL HAS NOT VERIFIED THE ACCURACY AND/OR COMPLETENESS OF THIS INFORMATION AND SHALL NOT BE RESPONSIBLE FOR ANY ERRORS OR OMISSIONS WHICH MAY BE INCORPORATED HEREIN AS A RESULT. THE TERM "CERTIFICATION" AS USED HEREIN SHALL BE AS SET FORTH IN STATE RULE 61G15-18-011(4).

Existing	Proposed
N/A	PROPOSED GRADE
---	EXISTING GRADE
N/A	STRUCTURE #
	8

VIRGINIA CROSSING

HIGHMARK DEVELOPMENT GROUP, Inc.

LMA
London, Moore & Associates, Inc.
CIVIL & ENVIRONMENTAL ENGINEERS
PLANNERS - SURVEYORS

34622 US 19 NORTH, PO Box 14272, FL 34664
Phone (813) 785-5010 FAX (813) 787-4394

PROFILES

8 OF 17